

TENANT NAME	UNIT NO	SANCTION AREA (SQ.FT.)	PROPOSED AREA (SQ.FT.)	THIS DRAWING IS A PRIVATE AND CONFIDENTIAL COMMUNICATION AND THE PROPERTY OF MANIRAMKA AND ASSOCIATES AND MUST NOT BE COPIED OR LENT WITHOUT THE CONSENT OF MANIRAMKA AND ASSOCIATES.
BAJUNATH & SONS	2201	601	607	STRUCTURE SHOWN IN YELLOW FIRM LINE ARE SANCTIONED & SHALL BE CONSTRUCTED.
SHRAWAN KUMAR AGARWAL	2202	565	569	
PRAHLADKA CONSULTANCY SERVICES P. LTD.	2203	194	204	
RAM PRASAD & SONS	2204	482	483	
SRC METALIC PVT. LTD.	2205	1102	1104	STRUCTURE SHOWN IN YELLOW DOTTED LINE ARE SANCTIONED BUT SHALL NOT BE CONSTRUCTED.
UNION COMM. ENTERPRISES	2207	5869	4967	STRUCTURE SHOWN IN RED HATCH ARE NOT SANCTIONED BUT PROPOSED FOR CONSTRUCTION.
UNION COMM. ENTERPRISES	2207A		883	
CALCUTTA CHAMBER OF TRADE	2208	655	574	
SREE MA STORES	2209	26	36	
BBWL	2210		365	

DECLARATION

CERTIFICATE OF ARCHITECT

I CERTIFY WITH FULL RESPONSIBILITY THAT THE BUILDING PLAN HAS BEEN DRAWN AS PER PROVISION OF K.M.C. BUILDING RULES 2009 AS AMENDED FROM TIME TO TIME AND THE SITE CONDITION INCLUDING WIDTH OF THE ABUTTING ROAD (31.268 MT) CONFORMS WITH THE PLAN WHICH HAS BEEN MEASURED & VERIFIED BY ME. IT IS A BUILDABLE SITE NOT A TANK OR FILLED UP TANK. THE LAND IS DEMARCATED BY BOUNDARY WALL. EXISTING STRUCTURE SHALL BE DEMOLISHED BEFORE COMMENCEMENT OF THE CONSTRUCTION WHICH IS FULLY OCCUPIED BY THE OWNER & TENANTS.

SUNIL MANIRAMKA, (B.Arch.)
Consulting Architect
Council of Architecture (Reg. No. 16/03/16636)

SIG. OF ARCHITECT

CERTIFICATE OF STRUCTURAL ENGINEER

THE STRUCTURAL DESIGN & DRAWING OF THE BOTH FOUNDATION AND SUPER STRUCTURE OF THE BUILDING HAS BEEN MADE BY ME CONSIDERING ALL THE POSSIBLE LOADS INCLUDING SEISMIC LOAD AS PER THE NATIONAL BUILDING CODE OF INDIA AND CERTIFY THAT IT IS SAFE, STABLE IN ALL RESPECT. SOIL TESTING REPORT HAS BEEN DONE BY SKM GEOSURVEY, BK-130, SALT LAKE, KOLKATA-700091. THE RECOMMENDATION OF REPORT HAS BEEN CONSIDERED DURING STRUCTURAL CALCULATION.

SANJIB GUHA
M.E.S.F.A.T.L.E.(CONSTR. ENG.),
B.C.E.(FIF-018700-4)
E.S.E.No.184(I) K.M.C.

SIG. OF STR. ENGINEER

CERTIFICATE OF STRUCTURAL REVIEWER

THIS IS TO CERTIFY THAT I HAVE REVIEWED THE STRUCTURAL DESIGN OF PROPOSED PREMISES CONSIDERING ALL POSSIBLE LOADS INCLUDING SEISMIC LOAD AS PER PROVISION OF RELEVANT S CODE. AND IT IS ALSO CERTIFIED THAT THE BUILDING IS SAFE AND STABLE IN ALL RESPECT.

SANJIB GUHA
BSC, DCE, FIE (P-115854-5)
M.E.S.F.A.T.L.E.(CONSTR. ENG.),
B.C.E.(FIF-018700-4)
E.S.E.No.184(I) K.M.C.

SIG. OF STR. REVIEWER

CERTIFICATE OF THE GEO-TECHNICAL ENGINEER

IT IS CERTIFIED THAT THE COMPREHENSIVE GEO-TECHNICAL REPORT ON SOIL INVESTIGATION HAS BEEN PREPARED BY ME FOR DESIGN AND CALCULATION OF THE FOUNDATION BY ANALYZING THE SOIL SAMPLE FOR ESTIMATING THE BEARING CAPACITY OF THE SOIL ON WHICH FOUNDATION OF THE STRUCTURE WILL BE CONSTRUCTED. I SHALL ALSO CHECK THE NATURE OF THE SOIL AFTER EXCAVATION AT SITE SO THAT FOUNDATION IS EXTENDED UP TO APPROPRIATE DEPTH THAT HAS BEEN PROPOSED IN THE GEO-TECHNICAL REPORT.

JITENDRA PAL
B.Tech (CIVIL), M.Tech (Geotech)
RAC Reg. No. G-7/1/32
G.T. No. 10/10463
22/BJSDR/G-7/1/2016-17
IITC Reg. No. 5072/CLASS-4/15

SIG. OF GEO-TECHNICAL ENGINEER

CERTIFICATE OF OWNER

WE DO HEREBY UNDERTAKE WITH FULL RESPONSIBILITY THAT -
1) WE SHALL ENGAGE L.B.A. & E.S.E DURING CONSTRUCTION.
2) WE SHALL FOLLOW THE INSTRUCTION OF L.B.A. & E.S.E DURING CONSTRUCTION OF THE BUILDING (AS PER B.S.PLAN)
3) K.M.C. AUTHORITY WILL NOT BE RESPONSIBLE FOR STRUCTURAL STABILITY OF THE BUILDING & ADJOINING STRUCTURE.
4) IF ANY SUBMITTED DOCUMENTS ARE FOUND TO BE FAKE, THE K.M.C. AUTHORITY WILL REVOKE THE SANCTION PLAN.
5) THE CONSTRUCTION OF WATER RESERVOIR AND SEPTIC TANK WILL BE UNDER THE GUIDANCE OF L.B.A. / E.S.E. BEFORE STARTING OF BUILDING FOUNDATION WORK.

For Bengal Bonded Warehouse Limited
Director.

SIG. OF OWNER

AMENDED PLAN OF PROPOSED G+39 (155.00 MT HT.) STORIED 'MEGA COMMERCIAL PROJECT' AT PREMISES NO: 25, NETAJI SUBHAS ROAD, WARD NO - 45, BOROUGH - V, P.S. - HARE STREET, KOLKATA - 700001. UNDER KOLKATA MUNICIPAL CORPORATION. AS PER SECTION 412A OF KOLKATA MUNICIPAL CORPORATION ACT 1980, READ WITH SECTION 394 OF KMC ACT 1980 ALONG WITH RULE 26 (2a & 2b) OF KMC BUILDING RULE 2009

PREVIOUS KMC SANCTION PERMIT NO : 2023050011 DATED : 21.07.2023 FOR BUILDING HEIGHT (G+32) 127.20 MT

SANCTION DRAWING


22ND FLOOR PLAN

STRUCTURAL ENGINEER : SPA CONSULTANTS (SPA)
34 RAMMOHAN DUTTA ROAD, KOLKATA-700020
Email: spa_cons@yahoo.co.in

DATE : 24.09.2024 | SCALE: 1:100 | DEALT: MAHAU | DRG-NO-25 H.S. ROAD/SD/23

ARCHITECTS : MANIRAMKA AND ASSOCIATES
74 B, A. J. C. ROSE ROAD, KOLKATA-700 016
PHONE : (033) 2217 8329
E mail: maniramka.associates@gmail.com
www.maniramkaarchitect.com

SHEET 23

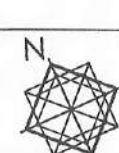


PARTY'S COPY

Plan for Water Supply arrangement including SEMILI G. & O. H. reservoirs should be submitted at the Office of the Ex-Engineer Water Supply and the sanction obtained before proceeding with the work of Water Supply any deviation may lead to disconnection/demolition.

Before starting any Construction the site must conform with the plans sanctioned and all the conditions as proposed in the plan should be fulfilled.
The validity of the written permission to execute the work is subject to the above conditions.

The sanction refers to the proposed portion shown in red and the Executive Engineers makes no admission as to the correctness of the plan.

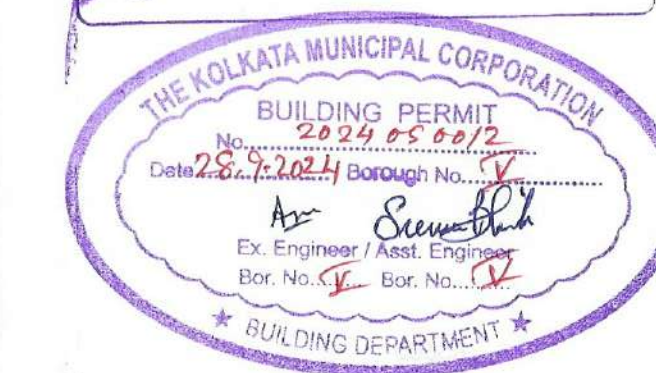

Design of all Structural Members including that of the foundation should conform to Standards specified in the National Building Code of India.

CONSTRUCTION SITE SHALL BE MAINTAINED TO PREVENT MOSQUITO BREEDING AS REQUIRED U/S 495 (1) & (2) OF C.M.C. ACT 1986. IN SUCH MANNER SO THAT ALL WATER COLLECTION & PARTICULARLY LIFT WELLS, VATS, BASEMENT CURING SITES, OPEN RECEPTACLES ETC. MUST BE EMPTIED COMPLETELY TWICE A WEEK.

The building materials that will be stacked on Road/Passage or Foot-path beyond 3-months or after construction of G Floor, whichever is earlier may be seized forthwith by the K.M.C. at the cost and risk of the owner.

No rain water pipe should be fixed or discharged on Road or Footpath. Drainage plan should be submitted at the Borough Executive Engineer's Office and the sanction obtained before proceeding with the drainage work.

A suitable pump has to be provided i.e. pumping unfiltered water for the distribution to the flushing cisterns and urinals in the building incase unfiltered water from street main is not available.

Non Commencement of Erection/ Re-Erection within Five year will Require Fresh Application for Sanction

BUSINESS BUILDING

THE SANCTION IS VALUED UP TO 27.9.2009

DEVIATION WOULD MEAN DEMOLITION
Necessary steps should be taken for the safety of the lives of the adjoining public and private properties during construction




